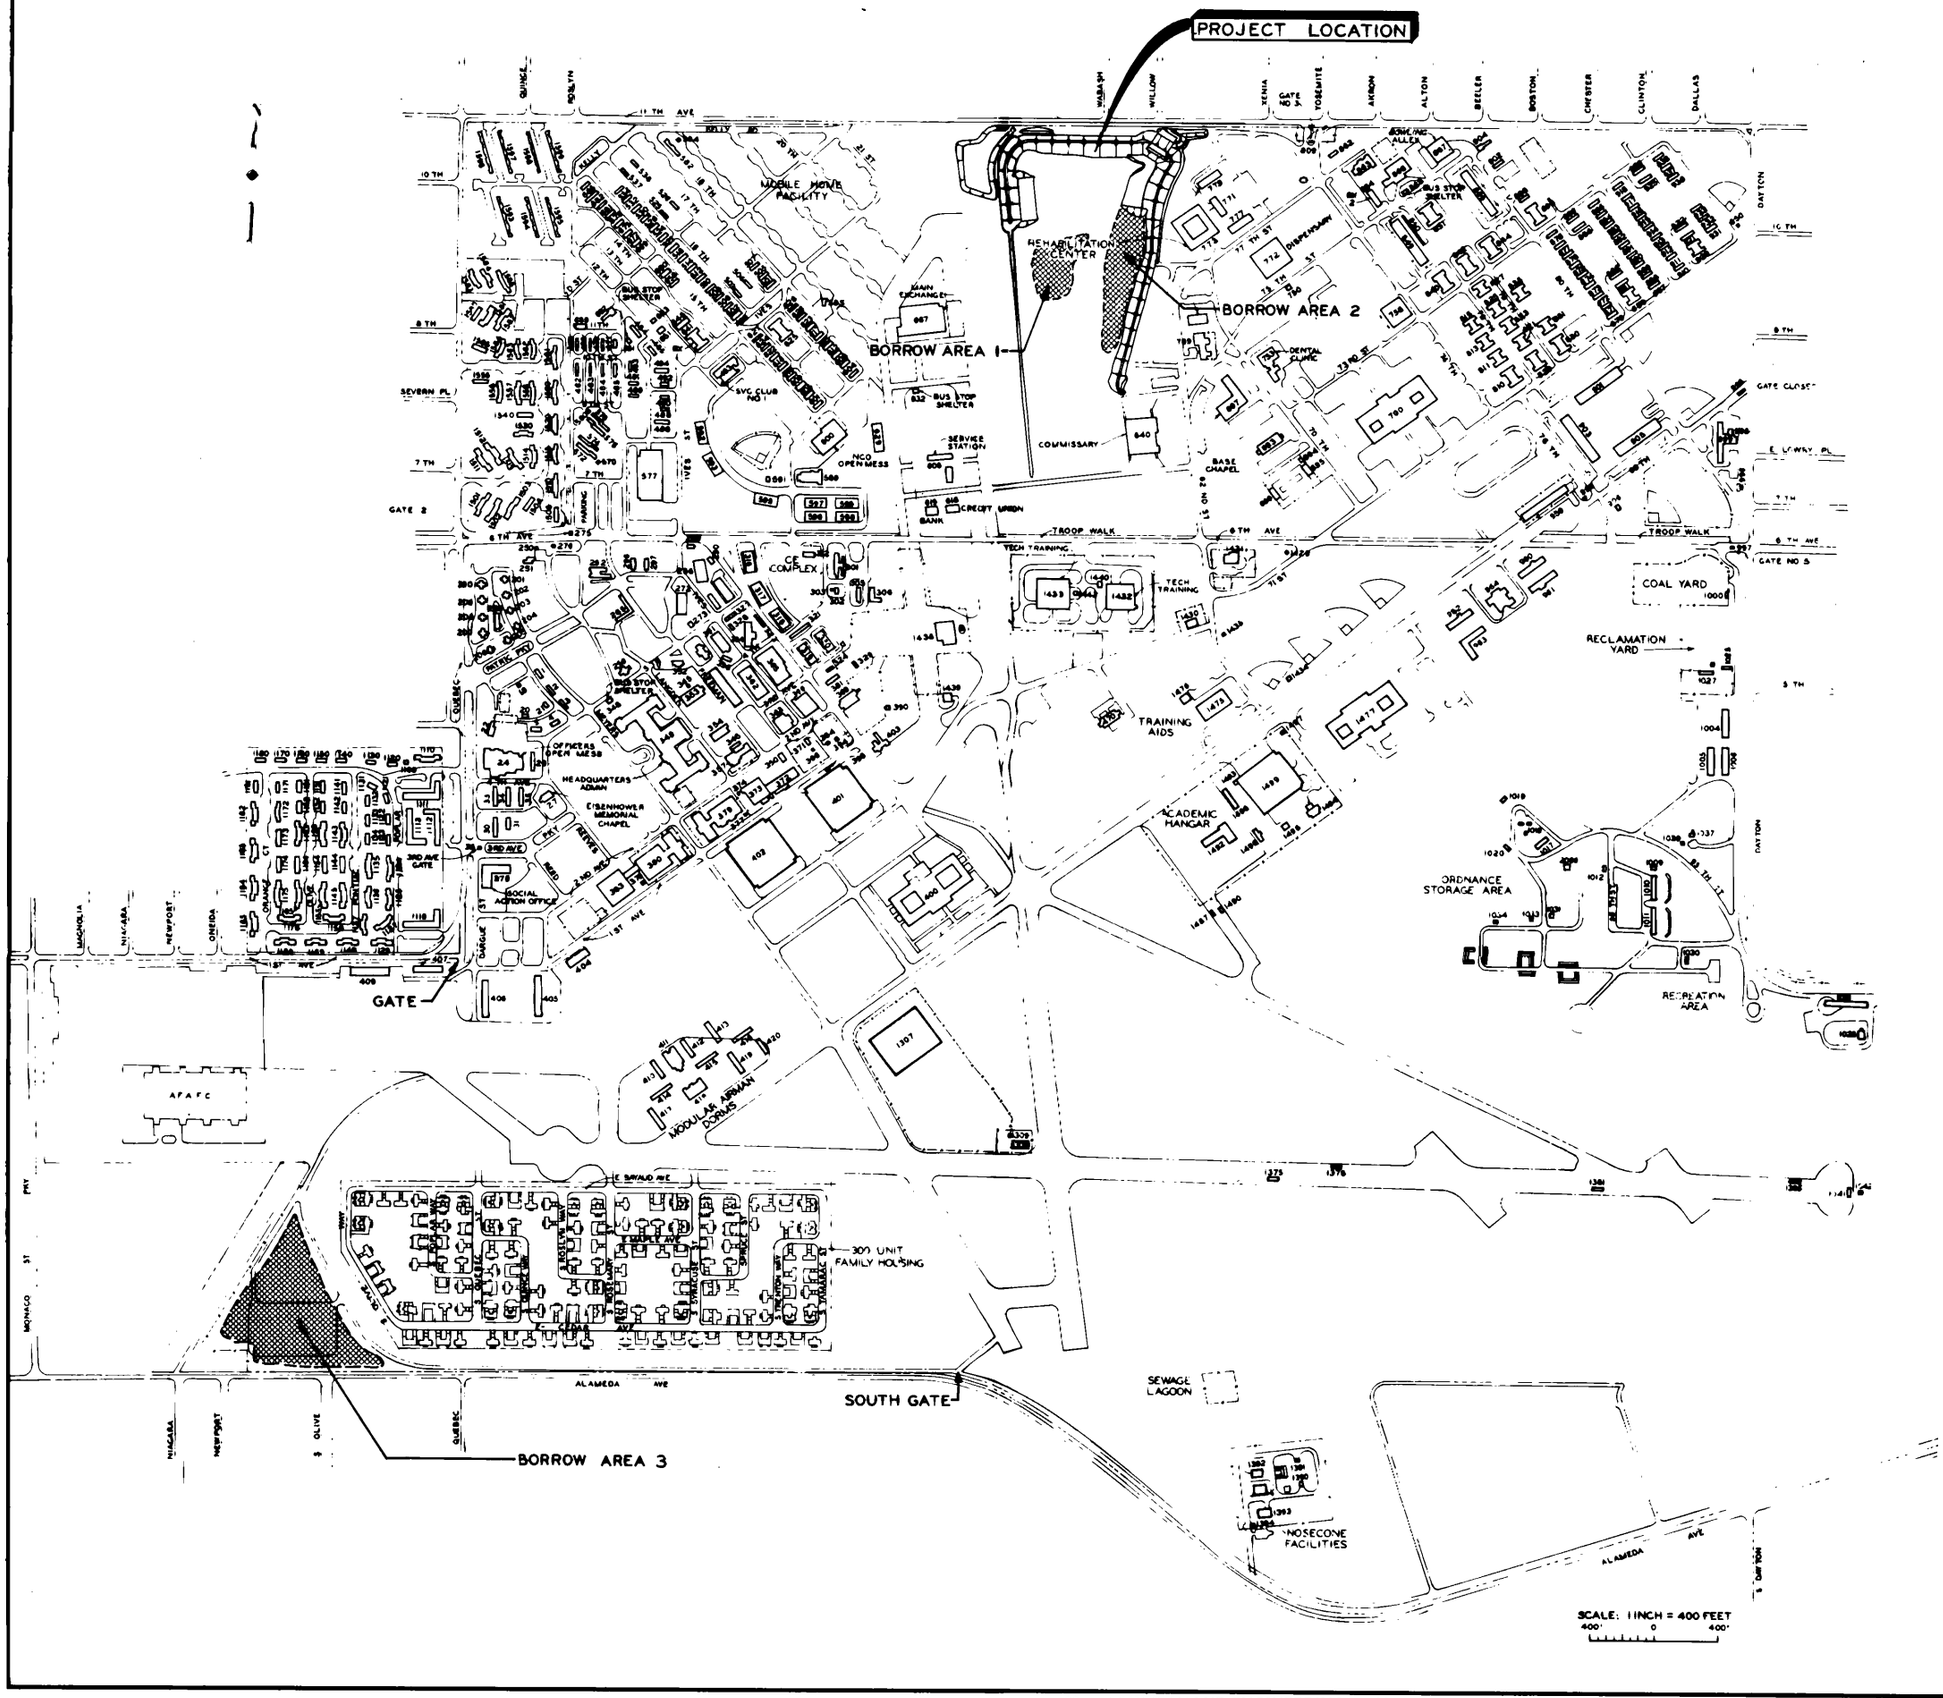

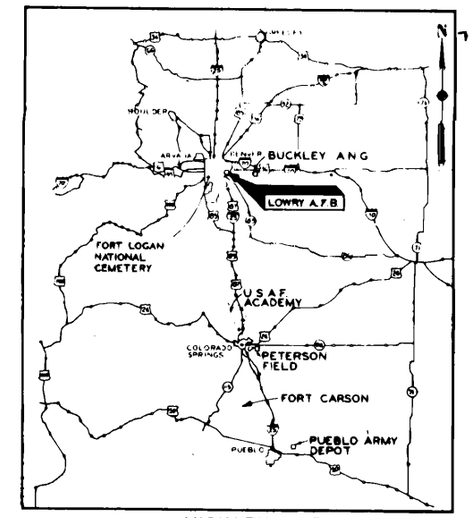

VICINITY MAP
NO SCALE

"AS-BUILT" INDEX

TITLE	DRAWING NO.
PROJECT LOCATION MAP & INDEX	SPK1-41E1
GENERAL PLAN	SPK1-41E2
OUTLET WORKS EXCAVATION PLAN, ℄ PROFILE & SECTION	SPK1-41E3
SPILLWAY - FINAL GRADING PLAN	SPK1-41E6
EMBANKMENT CENTERLINE PROFILE	SPK1-41E7
EMBANKMENT SECTIONS SHEET 1	SPK1-41E8
EMBANKMENT SECTIONS SHEET 2	SPK1-41E9
SPILLWAY PROFILES	SPK1-41E10
SPILLWAY SECTIONS SHEET 1	SPK1-41E11
SPILLWAY SECTIONS SHEET 2	SPK1-41E12
RECORD OF BORINGS SHEET 1	SPK1-41E13
RECORD OF BORINGS SHEET 2	SPK1-41E14
RECORD OF BORINGS SHEET 3	SPK1-41E15
OUTLET WORKS PLAN AND PROFILE	SPK1-41E16
OUTLET WORKS INTAKE STRUCTURE-CONCRETE DETAILS	SPK1-41E17
OUTLET WORKS CONDUIT END TRANSITION	SPK1-41E20
OUTLET WORKS MISCELLANEOUS DETAILS	SPK1-41E21
SPILLWAY - PLAN AND SECTION	SPK1-41E22
SPILLWAY REINFORCING	SPK1-41E23
SPILLWAY - DRAINAGE DETAILS	SPK1-41E24
MISCELLANEOUS METALS	SPK1-41E25
DRAINAGE STRUCTURES STA. 46+50 AND STA. 37+40	SPK1-41E26
UTILITY RELOCATIONS	SPK1-41E27
SANITARY SEWER RELOCATIONS PROFILES AND DETAILS	SPK1-41E28

THIS DRAWING HAS BEEN REDUCED TO THREE-EIGHTHS THE ORIGINAL SCALE.

U. S. ARMY ENGINEER DISTRICT, OMAHA
CORPS OF ENGINEERS
OMAHA, NEBRASKA

SOUTH PLATTE RIVER BASIN
KELLY ROAD DAM - WESTERLY CREEK
DAM REHABILITATION
GENERAL PLAN, VICINITY MAP AND "AS-BUILT" INDEX

DESIGNED BY:
DRAWN BY: J.L.C.
CHECKED BY:
SUBMITTED BY:
CHIEF DESIGN
RECOMMENDED: CHIEF DESIGN BRANCH
APPROVED: CHIEF ENGINEERING DIVISION
DATE: JUN. 1978
APPROVED: DIV. U.S.C. DISTRICT ENGINEER
SCALE: AS SHOWN
SPEC. NO. DACW45-78-B-0079
DRAWING NUMBER SPK1-41E1
SHEET

$$ – THINK VALUE ENGINEERING – $$

APPENDIX B OPERATION & MAINTENANCE PLATE 1